



PROPOSED 69 KV DEAD-END STRUCTURE-T3  
SECTION VIEW LOOKING NORTH

1  
E-04

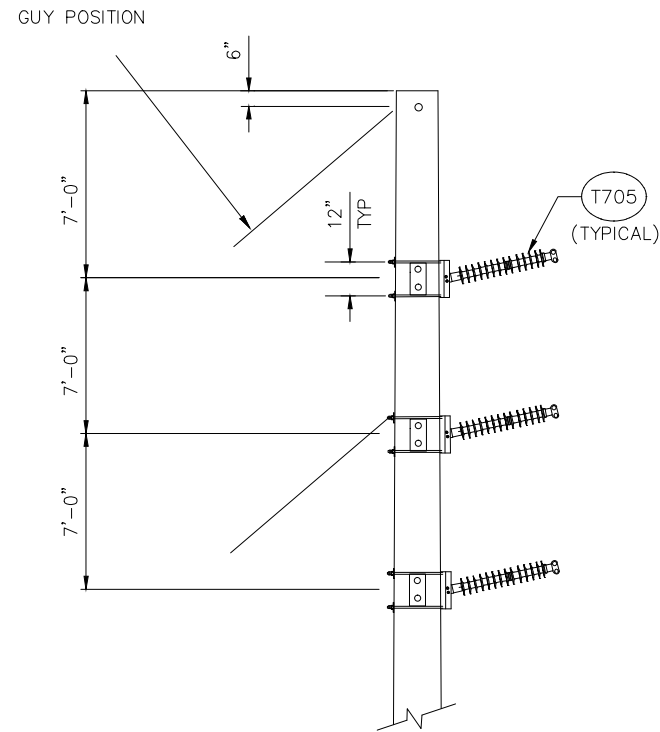


SECTION  
VIEW LOOKING EAST

A  
E31

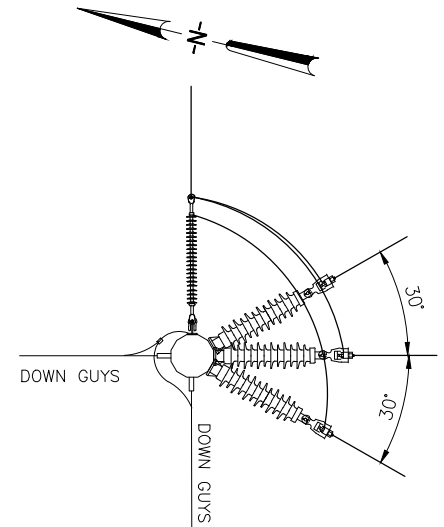

TOP VIEW

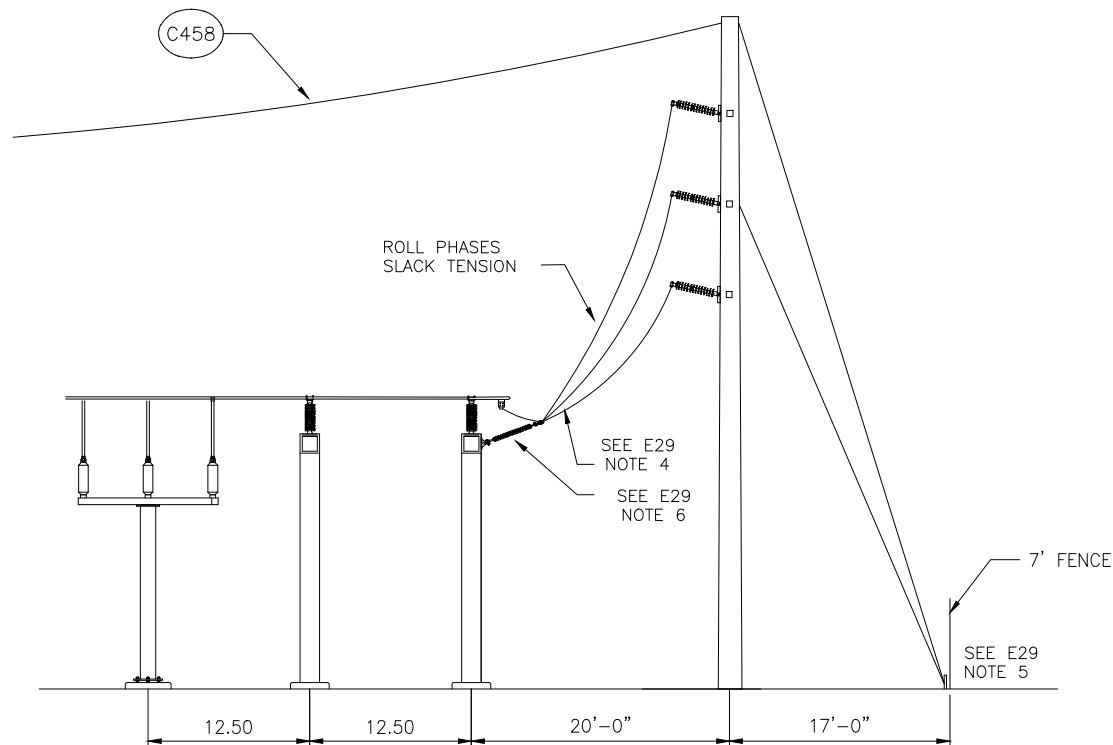

ELEVATION DETAIL  
VIEW LOOKING WEST

RECORD DRAWING	
By: RODGER V. WARREN	Date: OCT. 2010
CONTRACT NAME (CONSTRUCT ADMIN) POWERTOWN LINE CONSTRUCTION, LLC	
THIS DOCUMENT HAS BEEN PREPARED BASED ON INFORMATION PROVIDED BY THE CLIENT. THE USER OF THIS DOCUMENT SHALL BE RESPONSIBLE FOR THE ACCURACY OF EACH INFORMATION AND NOT OTHERWISE RESPONSIBLE. THIS DOCUMENT IS NOT TO BE USED FOR ANY OTHER PROJECTS WITHOUT THE WRITTEN PERMISSION OF JONES EDMUNDS & ASSOCIATES, INC.	
PHIL WEERS	Date: _____
JONES EDMUNDS & ASSOCIATES, INC.	


DESIGNED	AO
DRAWN	AO



WAUCHULA SUBSTATION RESTORATION/EXPANSION  
WAUCHULA, FLORIDA

SECTION "B" T3 TRANSMISSION  
DETAILS

CERTIFICATE OF AUTHORIZATION #1841	DATE AUG 2009	PROJECT NO. 07602-032-01
APPROVED BY PHIL WFRFR	SCALE	DWG. NO.