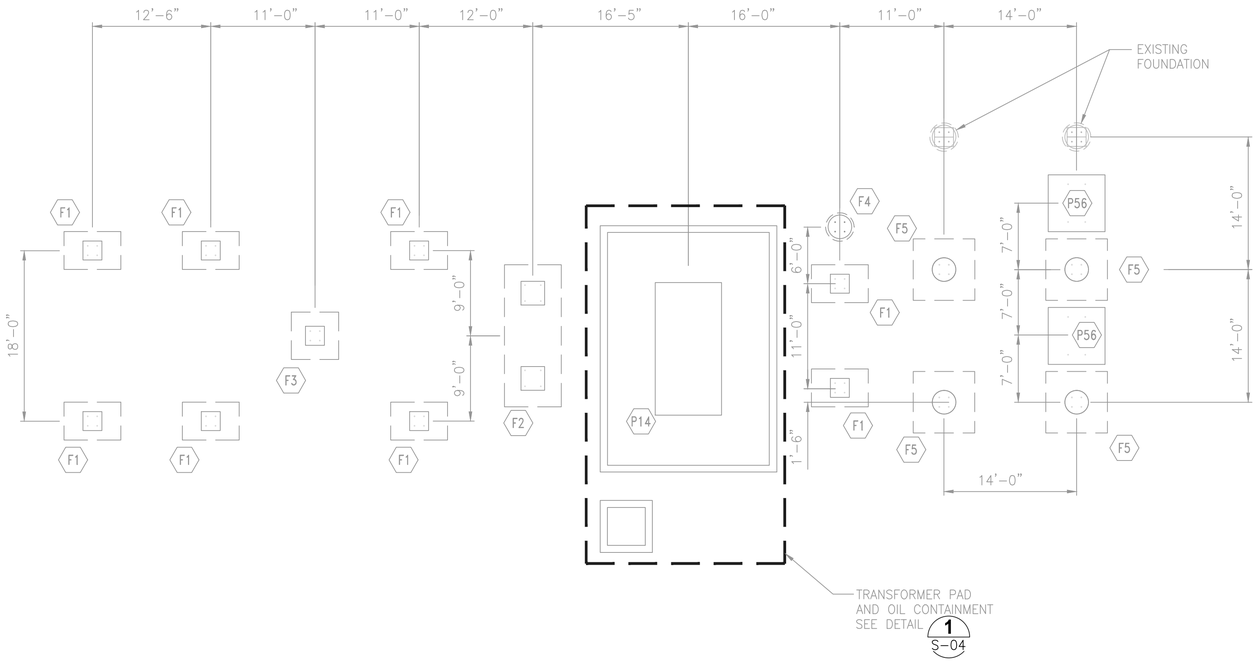

NOTE: SEE SHEET S-02 AND S-03 FOR FOUNDATION DETAILS AND REINFORCEMENT SCHEDULE.

FOUNDATION NOTES :

1. FOUNDATION DESIGN BASED ON: MAXIMUM ALLOWABLE BEARING PRESSURE – 2500 PSF MINIMUM DEPTH.
2. CONCRETE WORK SHALL CONFORM TO ACI SPECIFICATIONS FOR STRUCTURAL CONCRETE FOR BUILDINGS, ACI 301 LATEST EDITION.
3. STEEL WORK SHALL CONFORM TO THE AISC SPECIFICATIONS FOR STRUCTURAL STEEL BUILDINGS – ALLOWABLE STRESS DESIGN AND LOAD RESISTANCE FACTOR DESIGN.
4. CONCRETE TESTING FOR QUALITY IS THE RESPONSIBILITY OF THE CONTRACTOR AND THE FREQUENCY AND TYPES OF TESTING SHALL BE DETERMINED BY THE OWNER.
5. EARTH WALLS SHALL BE PROTECTED FROM CAVE-INS AND INTRUSION OF WATER. (IF NECESSARY, PROTECTION SHALL BE VIA TEMPORARY STEEL LINER. LINER SHALL BE REMOVED AS CONCRETE IS POURED).
6. ALL WATER SHALL BE PUMPED FROM EXCAVATION BEFORE CONCRETE IS POURED; OTHERWISE CONCRETE SHALL BE PLACED VIA UNDERWATER TREMIE.
7. ALL CONCRETE POURS MADE WHEN TEMPERATURES RANGE BETWEEN 50°F AND 90°F, CAN BE MADE WITHOUT SPECIAL PROVISIONS.
8. CONCRETE SHALL BE MADE FROM TYPE I OR III CEMENT. CONCRETE FOR FOUNDATIONS, PIERS, WALLS, AND PADS SHALL HAVE A MINIMUM ULTIMATE COMPRESSIVE STRENGTH OF 4000 P.S.I. AT 28 DAY TEST. CONCRETE FOR POLE FOUNDATION SHALL HAVE A MINIMUM ULTIMATE COMPRESSIVE STRENGTH OF 4000 P.S.I. AT 28 DAY TEST.
9. ALL REINFORCING STEEL SHALL BE NEW BILLET, 60 KSI DEFORMED BARS (ASTM A-615).
10. ALL DETAILING, FABRICATION, PLACING AND SUPPORTING OF REINFORCEMENT SHALL BE IN ACCORDANCE WITH ACI 318-08 AND C.R.S.I.
11. ALL REINFORCING AND ANCHOR BOLTS SHALL BE RIGIDLY SECURED IN POSITION BY TEMPLATE PRIOR TO THE PLACING OF CONCRETE.
12. ALL CONCRETE SHALL HAVE A MAXIMUM 4" SLUMP (UNLESS APPROVED ADMIXTURES ARE USED).
13. THE FOLLOWING MINIMUM CONCRETE COVER SHALL BE PROVIDED FOR REINFORCEMENT (UNO): MIN. COVER (IN)
    (A) CONCRETE CAST AGAINST AND PERMANENTLY EXPOSED TO EARTH 3"
    (B) CONCRETE EXPOSED TO EARTH AND WEATHER 3"
    (C) POLE FOUNDATION 3½"
14. ALL REINFORCEMENT AND WELDED WIRE FABRIC SHALL BE FREE OF RUST, DIRT, OIL AND MILL SCALE PRIOR TO PLACEMENT OF CONCRETE.
15. ALL ANCHOR BOLTS SHALL BE ASTM A-36, WITH (2) ASTM A-307 HEAVY HEX NUTS AND (2) FW OR ASTM A615-GR75, WITH (2) ASTM A-563 HEAVY HEX NUTS AND (2) FW EACH, AND SHALL BE GALVANIZED ACCORDING TO ASTM A-123, UNLESS NOTED OTHERWISE.
16. PORTLAND CEMENT SHALL CONFORM TO ASTM C150.
17. AGGREGATE FOR CONCRETE SHALL CONFORM TO ASTM C33, SIZE #57.
18. PROVIDE BAR SUPPORTS, SPACERS, AND OTHER ACCESSORIES AS REQUIRED BY THE LATEST CRSI MANUAL OF STANDARD PRACTICE.
19. REINFORCING BARS SHALL NOT BE WELDED.
20. PROVIDE HOOKS AT DISCONTINUOUS ENDS OF TOP BARS.
21. ONLY CONCRETE ABOVE THE GROUNDLINE SHALL BE FORMED.
22. ALL EXPOSED EDGES OF THE CONCRETE FOUNDATION SHALL BE BEVELED 3/4". ALL BACKFILL MUST BE COMPACTED
23. SLAB ON GRADE FOUNDATIONS TO BE PLACED ON A MINIMUM OF
24. 1'-0" OF COMPACTED STRUCTURAL FILL. THOROUGHLY COMPACT THE SELECT GRANULAR FILL TO THE ACCEPTANCE OF THE OWNER.
25. SHORING MAY BE NECESSARY FOR FOOTING CONSTRUCTION IF HORIZONTAL CLEARANCE TO EXISTING STRUCTURES DOES NOT ALLOW FOR A 2:1 EXCAVATION SLOPE TO THE BOTTOM OF FOOTING ELEVATION.
26. POLE FOUNDATIONS ARE DESIGNED AND ASSUMED TO BE CAST-IN-PLACE CONCRETE DRILLED SHAFT, DEEP FOUNDATIONS.
27. VERIFY ALL DIMENSIONS AND SITE CONDITIONS PRIOR TO STARTING CONSTRUCTION. NOTIFY THE ENGINEER OF ANY DISCREPANCIES OR INCONSISTENCIES.
28. DO NOT SCALE DRAWINGS.
29. THE ELEVATIONS ON THE SURVEY ARE GIVEN FOR THE TOP OF ROCK, NOT SOIL. THERE IS TYPICALLY 4" TO 6" OF ROCK ON TOP OF THE SOIL. TOP OF FOUNDATIONS SHALL BE AT EL. 105.4 WITH TOP OF ROCK 4" BELOW THE TOP OF FOUNDATION.
30. THE POLE FOUNDATION CONTRACTOR SHALL HAVE BEEN ENGAGED IN THE SUCCESSFUL INSTALLATION OF DEEP FOUNDATIONS FOR AT LEAST THREE YEARS.
31. WIND LOADS CALCULATION ARE IN ACCORDANCE WITH ASCE 7-05. THE WIND VELOCITY: 110 MPH, IMPORTANCE FACTOR I=1.15 AND EXPOSURE "C"
32. COMPACT BEARING SOIL TO A MINIMUM OF 95% FOR SLAB ON GRADE.
33. REMOVE FREE STANDING WATER FROM EXCAVATIONS BEFORE PLACING CONCRETE. POLE FOUNDATION CONCRETE SHALL BE PLACED IN SUCH A MANNER AS TO ENSURE THE EXCLUSION OF ANY FOREIGN MATTER AND TO SECURE A FULL-SIZED SHAFT. CONCRETE SHALL NOT BE PLACED THROUGH WATER EXCEPT WHERE A TREMIE OR OTHER APPROVED METHOD IS USED.
34. IF CASING WILL BE SELECTED, CYLINDER CASING SHALL BE OF SUFFICIENT STRENGTH AND RIGIDITY TO WITHSTAND ALL INSTALLATION STRESSES, TO PREVENT COLLAPSE DUE TO SOIL OR HYDROSTATIC PRESSURE.
35. THE MAXIMUM PERMISSIBLE VARIATION OF THE CENTER OF PILE FROM THE REQUIRED LOCATION IS 2 INCHES AT THE GROUND SURFACE. NO PILE SHALL BE OUT OF REQUIRED AXIAL ALIGNMENT BY MORE THAN 2 PERCENT.
36. THE CONTRACTOR MAY CHANGE THE DESIGNED DIAMETER AND LENGTH OF THE DEEP FOUNDATION DURING TO COMPENSATE FOR UNANTICIPATED SOIL CONDITION. REVIEW AND WRITTEN APPROVAL SHALL BE REQUIRED PRIOR TO ANY CHANGES.
37. IN CASE THE FOUNDATION WILL BE INSTALLED BY THE "WET CONSTRUCTION METHOD," FDOT SUPPLEMENTAL SPECIFICATION 455 SHALL BE CONFIRMED.
38. NON-SHRINK, NON-METALLIC GROUT SHALL MEET THE REQUIREMENTS OF ASTM C-1107 GRADE B. THE MINIMUM COMPRESSIVE STRENGTH SHALL BE 7000 PSI AT 28 DAYS. "DAYTON SUPERIOR" 1107 ADVANTAGE GROUT IS RECOMMENDED.
39. SEE DWGS. S02 & S03 FOR FOUNDATION DETAILS.
40. ANCHOR BOLT SIZES AND PATTERNS ARE BASED ON EQUIPMENT AND WIND LOADS. IF PROPOSED ANCHOR BOLT SIZES AND/OR PATTERNS DIFFER FROM THOSE INDICATED ON THE CONTRACT DRAWINGS, PLEASE NOTIFY THE ENGINEER OF RECORD AND PROVIDE FOR REVIEW SIGNED AND SEALED CALCULATIONS FOR THE PROPOSED ANCHOR BOLTS.
41. REBAR SPLICE AND HOOK SCHEDULE

REBAR SIZE	Ld (CLASS A) F'c PSI 3000	Ld (CLASS A) F'c PSI 4000	Ld (CLASS B) F'c PSI 3000	Ld (CLASS B) F'c PSI 4000	STD HOOK LENGTH 90° Leh	90° Leh	180° Leh	180° Leh
#3	17"	15"	22"	20"	6"	6"	6"	4"
#4	22"	19"	27"	25"	8"	8"	8"	4"
#5	28"	24"	37"	32"	10"	10"	10"	5"
#6	33"	29"	43"	38"	12"	12"	12"	6"
#7	48"	42"	63"	55"	14"	14"	14"	7"
#8	55"	48"	72"	63"	16"	15"	16"	8"
#9	62"	54"	81"	71"	18"	19"	18"	11"
#10	70"	61"	91"	80"	20"	21"	20"	12"
#11	73"	67"	95"	87"	22"	23"	22"	13"

ABBREVIATIONS

ALUM	ALUMINUM
AB	ANCHOR BOLT
ACI	AMERICAN CONCRETE INSTITUTE
APP/APPRD	APPROVE, APPROVED
APPROX	APPROXIMATE
ASCE	AMERICAN SOCIETY OF CIVIL ENGINEERS
ASTM	AMERICAN SOCIETY FOR TESTING AND MATERIALS
BLDG	BUILDING
BOTT	BOTTOM
CIP	CAST-IN-PLACE
CJ	CONSTRUCTION JOINT
CLR	CLEARANCE
COL	COLUMN
CONN	CONNECTION
CONC	CONCRETE
CONT	CONTINUOUS
CRSI	CONCRETE REINFORCING STEEL INSTITUTE
CTRD	CENTERED
DET	DETAIL
DIA	DIAMETER
DN	DOWN
DWG	DRAWING
EA	EACH
ELEC	ELECTRICAL
ELEV/EL	ELEVATION
EQ	EQUAL
EW	EACH WAY
EXIST	EXISTING
FBC	FLORIDA BUILDING CODE
FDOT	FLORIDA DEPARTMENT OF TRANSPORTATION
FFE	FINISHED FLOOR ELEVATION
FIG	FIGURE
FIN	FINISHED
FL	FLOOR
FPC	FLORIDA PLUMBING CODE
FT	FOOT
GAL	GALLON
GALV	GALVANIZED
GR	GRADE
GS	GALVANIZED STEEL
HORIZ	HORIZONTAL
HS	HEADDED STUD
HT	HEIGHT
IN	INCH
KIP	1,000 POUND
KSI	KIP PER SQUARE INCH
LF	LINEAR FEET
MAX	MAXIMUM
MECH	MECHANICAL
MFR	MANUFACTURER
MIN	MINIMUM
MISC	MISCELLANEOUS
MPH	MILES PER HOUR
MTL	MATERIAL
N/A	NOT APPLICABLE
N/AVAIL	NOT AVAILABLE
NIC	NOT IN CONTRACT
No	NUMBER
NOM	NOMINAL
NTS	NOT TO SCALE
#	NUMBER DESIGNATION
OC	ON CENTER
OPPH	OPPOSITE HAND
OSHA	OCCUPATIONAL SAFETY AND HEALTH ADMINISTRATION
PLF	POUNDS LINEAL FEET
PSF	POUNDS SQUARE FEET
PSI	POUNDS SQUARE INCH
RAD	RADIUS
REQ	REQUIRED
S	SLOPE
SCH	SCHEDULE
SHT	SHEET
SIM	SIMILAR
SJRWMD	ST. JOHNS RIVER WATER MANAGEMENT DISTRICT
SPEC	SPECIFICATIONS, SPECIFIED
SQ	SQUARE
SS	STAINLESS STEEL
STD	STANDARD
STL	STEEL
T/	TOP OF
T&B	TOP AND BOTTOM
THK	THICK
TYP	TYPICAL
UNO	UNLESS NOTED OTHERWISE
VERT	VERTICAL
WGT	WEIGHT

RECORD DRAWING
By: RODGER V. WARREN (CONSTRUCTION ADMIN) Date OCT. 2010
CONSTR.ADMIN NAME (CONSTRUCT ADMIN)
POWERTOWN LINE CONSTRUCTION, LLC
THESE RECORD DRAWINGS WERE PREPARED BASED ON INFORMATION PROVIDED BY OTHERS WHICH HAS NOT BEEN VERIFIED. JONES EDMUNDS DOES NOT WARRANT THE ACCURACY OR COMPLETENESS OF THE INFORMATION SHOWN HEREON AND IS NOT RESPONSIBLE FOR ITS ACCURACY OR COMPLETENESS OR FOR ANY ERRORS OR OMISSIONS THAT MAY BE INCORPORATED INTO THIS DOCUMENT BASED ON THE INFORMATION PROVIDED.
WENJUN LI P.E. #56104 Date
JONES EDMUNDS & ASSOCIATES, INC.

N

GRAPHIC SCALE
0 3 6 12
SCALE IN FEET

LTR.	DATE	REVISIONS	BY	APPRD.

DESIGNED RDH
DRAWN RDH
CHECKED WL

JONES EDMUNDS
730 NE WALDO ROAD, GAINESVILLE, FLORIDA 32641 / (352) 377-5821
1100 CESERY BLVD - SECOND FLOOR, JACKSONVILLE, FLORIDA 32211 / (904) 744-5401

WAUCHULA SUBSTATION EXPANSION
WAUCHULA, FLORIDA

FOUNDATION PLAN

CERTIFICATE OF AUTHORIZATION #1841
APPROVED BY
WENJUN LI
P.E. # 56104

DATE AUG 2009
PROJECT NO. 07602-032-01
SCALE 1-1/2"=1'
DWG. NO. S-01

LAST SAVED: 5/14/2012 9:27 AM SHAFERKAMP